


SYMBOLS

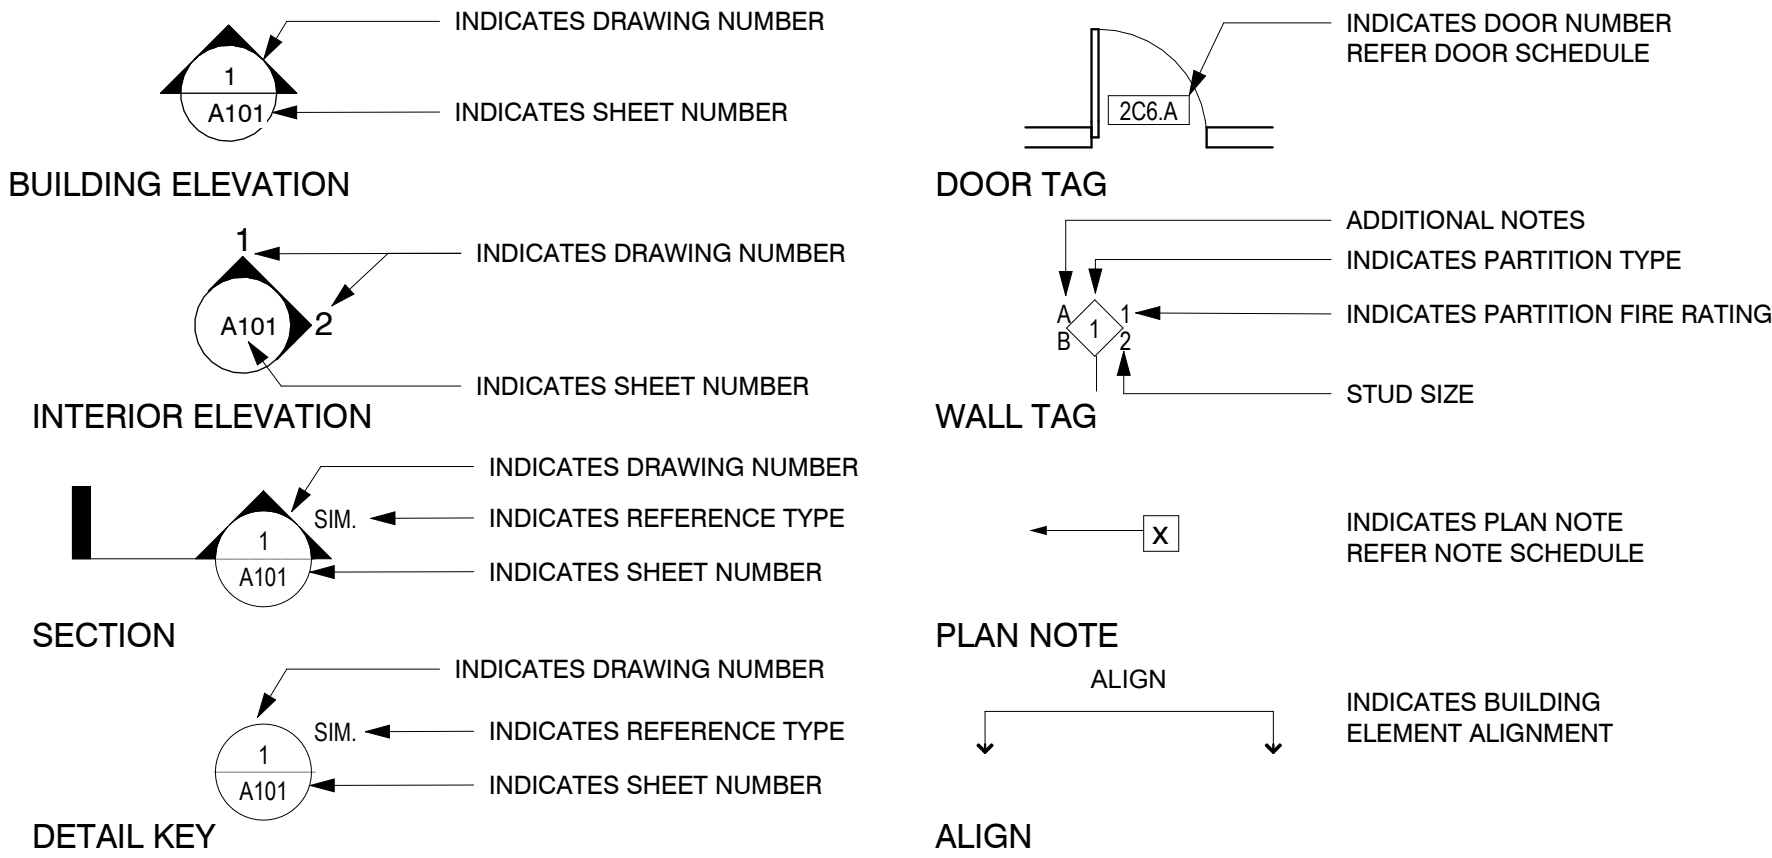

PROJECT GENERAL NOTES

THE FOLLOWING ARE GENERAL ADMINISTRATIVE NOTES. ADDITIONAL GENERAL NOTES MAY BE FOUND ON OTHER DRAWING SHEETS (E.G., STRUCTURAL, MEP, CIVIL). THE CONTRACTOR SHALL REVIEW ALL DOCUMENTS IN FULL AND NOTIFY THE ARCHITECT ON ANY DISCREPANCIES, ISSUES, OR REQUESTS FOR INFORMATION.

1. THESE DRAWINGS FORM PART OF THE CONTRACT DOCUMENTS AND ARE INTENDED FOR CONSTRUCTION. THEY INCLUDE ARCHITECTURAL PLANS, ELEVATIONS, SECTIONS, SCHEDULES, NOTES, AND DETAILS, AND MUST BE USED IN CONJUNCTION WITH THE PROJECT MANUAL, SPECIFICATIONS, ADDENDA, APPROVED SHOP DRAWINGS, APPROVED MODIFICATIONS, AND THE CONSTRUCTION CONTRACT AGREEMENT BETWEEN THE OWNER AND GENERAL CONTRACTOR.

2. THESE DRAWINGS, AND ANY ASSOCIATED CONTRACT DOCUMENTS, ARE INSTRUMENTS OF SERVICE PREPARED BY THE ARCHITECT AND REMAIN THE PROPERTY OF WOOD + STARR (MSAV, LLC). REGARDLESS OF PROJECT COMPLETION, REUSE, REPRODUCTION, DISTRIBUTION, OR MODIFICATION IS PROHIBITED WITHOUT PRIOR WRITTEN CONSENT AND COMPENSATION.

3. THESE DRAWINGS HAVE NO INHERENT HIERARCHY IN RELATION TO OTHER CONTRACT DOCUMENT. THE TOTALITY OF THE CONTRACT DOCUMENTS, INCLUDING THESE DRAWINGS, SHOULD BE REVIEWED AND INTERPRETED AS A SINGULAR DOCUMENT AND OF EQUAL IMPORTANCE THROUGHOUT, UNLESS SPECIFICALLY NOTED OTHERWISE.

4. WHERE HIERARCHY IS APPLICABLE, INTERPRET DOCUMENTS IN THE FOLLOWING ORDER: SPECIFICATIONS AND MANUFACTURER INSTALLATION REQUIREMENTS GOVERN OVER DRAWINGS; NOTED DIMENSIONS GOVERN OVER SCALED MEASUREMENTS; LARGER-SCALE DRAWINGS GOVERN OVER SMALLER-SCALE ONES; APPROVED SHOP DRAWINGS GOVERN OVER GENERAL DRAWINGS; ARCHITECTURAL DRAWINGS GOVERN THE PLACEMENT AND AESTHETICS OF FIXTURES AND EQUIPMENT OVER CONSULTANT DRAWINGS UNLESS SUCH PLACEMENT COMPROMISES SYSTEM REQUIREMENTS OR CRITICAL DETAILS. REPORT ERRORS, OMISSIONS, OR CONFLICTS TO THE ARCHITECT BEFORE PROCEEDING WITH RELATED WORK.

5. THESE DRAWINGS AVOID ABBREVIATIONS WHERE POSSIBLE. WHEN USED, THEY FOLLOW INDUSTRY CONVENTIONS. SEEK CLARIFICATION FROM THE ARCHITECT IF ANY TERM OR ABBREVIATION IS UNCLEAR.

6. STANDARDS REFERENCED MAY INCLUDE, BUT ARE NOT LIMITED TO:
A. AMERICAN SOCIETY FOR TESTING AND MATERIALS (ASTM)
B. AMERICAN INSTITUTE OF STEEL CONSTRUCTION (AISC)
C. AMERICAN WELDING SOCIETY (AWS)
D. AMERICAN CONCRETE INSTITUTE (ACI)
E. AMERICAN NATIONAL STANDARDS INSTITUTE (ANSI)
F. ARCHITECTURAL ALUMINUM MANUFACTURERS ASSOCIATION (AAMA)
G. ALUMINUM ASSOCIATION (AA)
H. CONCRETE REINFORCING STEEL INSTITUTE (CRSI)
I. NATIONAL ASSOC. OF ARCHITECTURAL METAL MANUFACTURERS (NAAMM)
J. NATIONAL FIRE PROTECTION ASSOCIATION (NFPA)
K. NATIONAL WOODWORK MANUFACTURERS ASSOCIATION (NWMA)

7. COMMON TERMS USED:
A. "FURNISH" = SUPPLY ONLY
B. "INSTALL" = PLACEMENT BY CONTRACTOR
C. "PROVIDE" = FURNISH AND INSTALL, COMPLETE IN PLACE
D. "U.O.N." = UNLESS OTHERWISE NOTED
E. "SIMILAR" = COMPARABLE IN FUNCTION/APPEARANCE, ABBREVIATED "SIM"
F. "TYPICAL" = REPEATS FOR SIMILAR CONDITIONS, ABBREVIATED "TYP"
G. "ALIGN" = TO BE FLUSH OR IN CONTINUOUS PLANE
H. "REFER" = DIRECT ATTENTION TO A SPECIFIC DRAWING, NOTE, DETAIL, SPECIFICATION, OR DOCUMENT FOR ADDITIONAL OR RELATED INFORMATION

8. REFER TO THE PROJECT DIRECTORY ON SHEET G1.00 FOR A COMPLETE LIST OF ALL PARTIES, CONTACTS, JURISDICTIONS, AND SUPPORTING DOCUMENTS ASSOCIATED WITH THESE DRAWINGS AND THE CONTRACT DOCUMENTS.

9. THE TERMS "OWNER," "TENANT," OR "CLIENT" IS THE PROJECT CLIENT, TENANT, OR END USER, UNLESS OTHERWISE NOTED. REFER TO THE PARTY IDENTIFIED IN THE PROJECT DIRECTORY ON SHEET G1.00.

10. THE TERM "ARCHITECT" REFERS TO WOOD+STARR (MSAV, LLC), LICENSED IN THE PROJECT JURISDICTION. THE ARCHITECT IS AN AGENT OF THE OWNER AND MAY SPEAK OR ACT ON THE OWNER'S BEHALF AS DIRECTED. THE CONTRACTOR IS EXPECTED TO COMPLY WITH DIRECTION FROM THE ARCHITECT WITHIN THE SCOPE OF THE CONTRACT DOCUMENTS.

11. THE TERM "CONSULTANT" REFERS TO ANY DESIGN CONSULTANT WORKING IN COORDINATION WITH THE ARCHITECT. THEIR DOCUMENTS ARE SUBJECT TO THE SAME TERMS AND ARE CONSIDERED AGENTS OF THE OWNER WHEN UNDER CONTRACT THROUGH THE ARCHITECT. COMMUNICATION SHOULD BE ROUTED THROUGH THE ARCHITECT UNLESS OTHERWISE DIRECTED.

12. THE TERMS "CONTRACTOR," "GC," OR "GENERAL CONTRACTOR" REFER TO THE ENTITY HOLDING THE CONSTRUCTION AGREEMENT WITH THE OWNER, INCLUDING THEIR SUBCONTRACTORS, UNLESS OTHERWISE NOTED.

13. THE TERMS "REVISION," "ADDENDUM," "CHANGE ORDER," OR "CHANGE OF SCOPE" REFER TO ANY FORMAL ALTERATION TO THE ORIGINAL CONTRACT DOCUMENTS OR CONSTRUCTION COST. CHANGES REQUIRE WRITTEN NOTICE TO AND APPROVAL BY THE ARCHITECT AND OWNER, WITH A MINIMUM OF FIVE (5) BUSINESS DAYS' NOTICE UNLESS NOTED OTHERWISE.

14. THE TERM "AUTHORITY (AGENCY) HAVING JURISDICTION" OR "AHJ" REFERS TO THE GOVERNING AUTHORITY. ALL WORK MUST COMPLY WITH APPLICABLE CODES, REGULATIONS, AND RULES FROM THESE ENTITIES, WHICH MAY BE NUMEROUS AND INCLUDE LOCAL, STATE, FEDERAL, OR OTHER RELEVANT BODIES. IN CASE OF CONFLICT, THE MOST STRINGENT REQUIREMENTS SHALL APPLY. NOTIFY THE ARCHITECT AND OWNER OF ANY DISCREPANCIES.

15. THE TERM "SITE" REFERS TO THE FULLEST EXTENT, EXISTING OR NEW, OF THE PROPERTY, BOUNDARY, OR AREA WHERE WORK UNDER THE CONTRACT DOCUMENTS IS TO BE PERFORMED, INCLUDING ALL SPACES IMPACTED BY CONSTRUCTION ACTIVITIES, STAGING, ACCESS, DELIVERY, AND OPERATIONS REGARDLESS OF WHETHER THEY ARE WITHIN THE PROJECT'S FOOTPRINT.

16. THE TERM "MEANS AND METHODS" SHALL REFER TO THE LABOR, CONSTRUCTION TECHNIQUES, SEQUENCES, PROCEDURES, SAFETY PRECAUTIONS, AND PROCESSES SELECTED BY THE CONTRACTOR TO PERFORM AND COMPLETE THE WORK. THE CONTRACTOR SHALL BE SOLELY RESPONSIBLE FOR DETERMINING AND CONTROLLING THE MEANS AND METHODS, UNLESS OTHERWISE SPECIFIED IN THE CONTRACT DOCUMENTS OR AS DIRECTED IN WRITING BY THE ARCHITECT WITH THE OWNER'S APPROVAL.

17. THE TERM "SUBSTANTIAL COMPLETION" SHALL MEAN THE STAGE IN THE PROGRESS OF THE WORK WHEN THE WORK OR DESIGNATED PORTION THEREOF IS SUFFICIENTLY COMPLETE, IN ACCORDANCE WITH THE CONTRACT DOCUMENTS, SO THAT THE OWNER MAY OCCUPY OR UTILIZE THE WORK FOR ITS INTENDED USE, AND ONLY PUNCH LIST ITEMS AND NON-MATERIAL CORRECTIONS REMAIN. SUBSTANTIAL COMPLETION SHALL BE ESTABLISHED BY THE ARCHITECT AND DOCUMENTED BY ISSUANCE OF A CERTIFICATE OF SUBSTANTIAL COMPLETION.

18. THE ARCHITECT'S AGREEMENT IS SOLELY WITH THE OWNER, INCLUDING ALL LIABILITIES AND INDEMNITY PERTAINING TO THE WORK AND CONTRACT DOCUMENTS. THERE IS NO CONTRACTUAL RELATIONSHIP BETWEEN THE ARCHITECT AND CONTRACTOR BEYOND THE CONTRACT DOCUMENTS.

19. THE ARCHITECT SERVES EXPRESSLY AS THE OWNER'S AGENT AND SHALL BE AUTHORIZED TO MAKE DECISIONS ON BEHALF OF THE OWNER AND WITH RESPECT TO THE WORK, EITHER AT THE OWNER'S DIRECTION OR IN THE OWNER'S ABSENCE. THE ARCHITECT SHALL HAVE FREE AND UNOBSTRUCTED ACCESS TO THE SITE AND PROJECT SPECIFIC DETAILS AT ALL TIMES.

20. THE ARCHITECT HAS SOLE AUTHORITY, ON BEHALF OF THE OWNER, TO DETERMINE CONFORMANCE OF MATERIALS, EQUIPMENT, AND SYSTEMS TO THE DESIGN INTENT. THIS INCLUDES REVIEW AND APPROVAL OF ALL ITEMS FOR INCORPORATION INTO THE WORK, INCLUDING CONTRACT MODIFICATIONS. NO DEVIATION IS PERMITTED WITHOUT PRIOR WRITTEN APPROVAL.

21. THE ARCHITECT HAS SOLE AUTHORITY, ON BEHALF OF THE OWNER, TO REVIEW AND APPROVE ALL CONTRACT MODIFICATIONS, INCLUDING CHANGE ORDERS. APPROVAL OF A CHANGE ORDER IS NOT GUARANTEED AND SHALL NOT BE ASSUMED. NO DEVIATION FROM THE CONTRACT DOCUMENTS IS PERMITTED WITHOUT THE ARCHITECT'S PRIOR WRITTEN APPROVAL.

22. THE ARCHITECT HAS SOLE AUTHORITY, ON BEHALF OF THE OWNER, TO REVIEW AND CERTIFY THE CONTRACTOR'S APPLICATIONS FOR PAYMENT. NO PAYMENT SHALL BE DUE UNLESS AND UNTIL THE ARCHITECT HAS REVIEWED THE REQUEST AND ISSUED A CERTIFICATE FOR PAYMENT. THE ARCHITECT'S REVIEW DOES NOT CONSTITUTE ACCEPTANCE OF NONCONFORMING WORK.

23. THE ARCHITECT'S INVOLVEMENT IN ARCHITECTURAL DRAWINGS, REVIEWS, AND SITE VISITS DO NOT RELIEVE THE CONTRACTOR OF RESPONSIBILITY FOR COMPLIANCE WITH CODE, CONSTRUCTABILITY, OR QUALITY. IF THE ARCHITECT'S DOCUMENTS CONFLICT WITH AHJ REQUIREMENTS, THE CONTRACTOR SHALL COORDINATE WITH THE ARCHITECT TO RESOLVE THE ISSUE AND ADJUST THE CONSTRUCTION CONTRACT AS APPROPRIATE.

24. THE CONTRACTOR SHALL BE RESPONSIBLE FOR THE MEANS AND METHODS OF THE WORK, UNLESS OTHERWISE NOTED IN THE CONTRACT DOCUMENTS OR DIRECTED IN WRITING BY THE ARCHITECT WITH THE OWNER'S APPROVAL.

25. THE CONTRACTOR SHALL COMPLY WITH ALL APPLICABLE TERMS AND CONDITIONS OF THE CONTRACT DOCUMENTS RELATED TO THE EXECUTION OF THE WORK. THE ARCHITECT AND OWNER ASSUME NO RESPONSIBILITY FOR THE CONTRACTOR'S MEANS AND METHODS UNLESS EXPRESSLY STATED.

26. THE CONTRACTOR SHALL BE RESPONSIBLE FOR REVIEWING ALL DOCUMENTS, VERIFYING FIELD CONDITIONS AND DIMENSIONS, AND RESOLVING DISCREPANCIES BEFORE BEGINNING WORK. REPORT CONFLICTS OR OMISSIONS TO THE ARCHITECT IMMEDIATELY. THE ARCHITECT AND OWNER ARE NOT LIABLE FOR COSTS ARISING FROM UNREPORTED ISSUES.

27. THE CONTRACTOR SHALL PROVIDE A CONSTRUCTION SCHEDULE WITHIN FIVE (5) BUSINESS DAYS OF CONTRACT EXECUTION AND UPDATE AS REQUIRED. COORDINATE WITH TRADES, ARCHITECT, CONSULTANTS, AND OWNER TO MAINTAIN PROJECT CONTINUITY. PROVIDE AT LEAST THREE (3) BUSINESS DAYS' NOTICE FOR UNSCHEDULED MEETINGS.

28. THE CONTRACTOR SHALL BE PERMITTED TO PROCEED WITH THE WORK IN ACCORDANCE WITH THE CONTRACT DOCUMENTS IF THE ARCHITECT IS UNAVAILABLE, UNREACHABLE, OR INCAPACITATED FOR UP TO SEVEN (7) CONSECUTIVE BUSINESS DAYS AND SHALL MAINTAIN A RECORD OF ANY ISSUES OR QUESTIONS THAT ARISE. IF THE ARCHITECT REMAINS UNAVAILABLE BEYOND THAT PERIOD, THE OWNER MAY PROVIDE AN ALTERNATE CONTACT OR DIRECTION. THE CONTRACTOR SHALL NOT INTERPRET OR ACT ON BEHALF OF THE ARCHITECT WITHOUT WRITTEN CONFIRMATION.

29. THE CONTRACTOR SHALL SECURE AND PAY FOR ALL REQUIRED PERMITS AND INSPECTIONS AND COORDINATE THEM WITH THE ARCHITECT AND AHJ, PROVIDING AT LEAST THREE (3) BUSINESS DAYS' NOTICE.

30. THE CONTRACTOR SHALL SECURE AND PAY FOR ALL REQUIRED MATERIALS AND EQUIPMENT REQUIRED FOR THE WORK, UNLESS OTHERWISE NOTED. THE CONTRACTOR SHALL ORDER AND DELIVER MATERIALS IN A TIMELY MANNER AND NOTIFY THE ARCHITECT IMMEDIATELY IF ANY SPECIFIED ITEMS ARE UNAVAILABLE.

31. THE CONTRACTOR SHALL MAINTAIN A CLEAN, ORGANIZED, AND SAFE JOBSITE AT ALL TIMES. THEY SHALL PROTECT ALL WORK, EQUIPMENT, AND SURROUNDING AREAS, AS WELL AS REMOVE DEBRIS REGULARLY AND RESTORE AFFECTED AREAS TO THEIR PRIOR CONDITION OR BETTER.

32. THE CONTRACTOR SHALL CONDUCT ALL WORK IN ACCORDANCE WITH OSHA SAFETY STANDARDS AND PROTECT EXISTING BUILDING SYSTEMS AND LIFE-SAFETY COMPONENTS THROUGHOUT ALL PHASES. THE SHALL COORDINATE SIGNAGE, LIGHTING, AND BARRIERS WITH THE ARCHITECT AND OWNER.

33. THE CONTRACTOR SHALL PROVIDE TEMPORARY PROTECTION FOR ALL NEW AND EXISTING WORK UNTIL FINAL ACCEPTANCE. THE CONTRACTOR IS RESPONSIBLE FOR ANY DAMAGE TO EXISTING OR NEW WORK, WHETHER ACCIDENTAL OR DELIBERATE.

34. THE CONTRACTOR SHALL VERIFY ALL SITE DIMENSIONS AND CONDITIONS PRIOR TO CONSTRUCTION. THEY SHALL NOT SCALE DRAWINGS, USING ONLY WRITTEN DIMENSIONS. THEY SHALL CONFIRM THE LAYOUT FOR PARTITIONS, DOORS, OUTLETS, SWITCHES, AND THERMOSTATS WITH THE ARCHITECT PRIOR TO INSTALLATION.

35. THE CONTRACTOR SHALL REPORT UNFORESEEN OR DIFFERING CONDITIONS TO THE ARCHITECT IMMEDIATELY AND AWAIT DIRECTION BEFORE PROCEEDING.

36. THE CONTRACTOR SHALL FREQUENTLY VERIFY THAT ALL ARCHITECTURAL, STRUCTURAL, AND MEP SYSTEMS HAVE ADEQUATE CLEARANCE FOR ACCESS AND MAINTENANCE. THE CONTRACTOR IS RESPONSIBLE FOR UNRESOLVED CONFLICTS OR ACCESS ISSUES.

37. THE CONTRACTOR SHALL SUBMIT SHOP DRAWINGS, PRODUCT DATA, SAMPLES, AND MANUFACTURER SPECS TO THE ARCHITECT AND CONSULTANTS FOR REVIEW BEFORE PROCUREMENT OR INSTALLATION. THE CONTRACTOR SHALL ALLOW TEN (10) BUSINESS DAYS FOR REVIEW, AND FIVE (5) BUSINESS DAYS FOR RESUBMITTALS.

38. THE CONTRACTOR SHALL NOT CONCEAL WORK REQUIRING REVIEW OR INSPECTION UNTIL APPROVED. CONCEALED, UNAPPROVED WORK MAY BE REJECTED AND MUST BE UNCOVERED AT THE CONTRACTOR'S EXPENSE.

39. THE CONTRACTOR SHALL NOT SUBSTITUTE MATERIALS WITHOUT WRITTEN APPROVAL FROM THE ARCHITECT. THEY SHALL SUBMIT FULL TECHNICAL DATA AND JUSTIFICATION FOR PROPOSED SUBSTITUTIONS.

40. THE CONTRACTOR SHALL INSTALL ALL ITEMS IN ACCORDANCE WITH MANUFACTURER INSTRUCTIONS. WHERE CONFLICTS ARISE, THE MORE STRINGENT REQUIREMENT SHALL APPLY.

41. THE CONTRACTOR SHALL COORDINATE SYSTEMS AND FINISHES TO ENSURE CLEARANCE AND INTEGRATION. SUBMIT PROPOSED SOFFITS OR FURRING ADJUSTMENTS TO THE ARCHITECT FOR REVIEW.

42. THE CONTRACTOR SHALL COORDINATE ALL TRADES TO MAINTAIN CEILING HEIGHTS AND DESIGN INTENT. RESOLVE ALIGNMENT CONFLICTS OF EQUIPMENT, FIXTURES, LIGHTING, DUCTS, PIPING, ETC. BEFORE INSTALLATION.

43. THE CONTRACTOR SHALL MAINTAIN ALL FIRE-RESISTANCE RATINGS AND LIFE-SAFETY MEASURES THROUGHOUT CONSTRUCTION. THIS INCLUDES PROVIDING CLEARLY LABELED PORTABLE FIRE EXTINGUISHERS WITH A MINIMUM RATING OF 1-A:10-B:C ON EACH FLOOR WHERE CONSTRUCTION ACTIVITIES OCCUR, IN SUFFICIENT QUANTITIES FOR EASE OF ACCESS AND AT A MINIMUM RATIO OF ONE EXTINGUISHER PER 11,250 SQUARE FEET OF WORK AREA. FIRE EXTINGUISHERS SHALL ALSO BE PROVIDED AT EACH STAIRWAY ON ALL FLOOR LEVELS WHERE COMBUSTIBLE MATERIALS HAVE ACCUMULATED, AND IN EVERY STORAGE AND CONSTRUCTION SHED. ADDITIONAL EXTINGUISHERS SHALL BE PROVIDED WHERE SPECIAL HAZARDS EXIST, SUCH AS THE STORAGE OR USE OF FLAMMABLE AND COMBUSTIBLE LIQUIDS.

44. THE CONTRACTOR SHALL COORDINATE ALL SHUTDOWNS, TIE-INS, AND SERVICE CHANGES WITH A MINIMUM OF FIVE (5) BUSINESS DAYS' NOTICE TO THE OWNER, ARCHITECT, AND AFFECTED OCCUPANTS, WHERE APPLICABLE. ALL SPRINKLER AND ALARM SHUTDOWNS, OR ANY OTHER LIFESAFETY-RELATED ACTIVITIES, SHALL REQUIRE SCHEDULED FIRE WATCH PERSONNEL TO BE ON SITE FOR THE DURATION OF THE IMPAIRMENT.

45. THE CONTRACTOR SHALL PROVIDE ALL CUTTING, PATCHING, AND FINISHING NEEDED FOR A COMPLETE INSTALLATION OF ANY WORK. THEY SHALL MATCH ADJACENT MATERIALS IN COLOR, TEXTURE, AND MATERIAL, SUBJECT TO ARCHITECT APPROVAL.

46. THE CONTRACTOR SHALL MAINTAIN COMPLETE PROJECT RECORDS, INCLUDING DAILY LOGS, INSPECTIONS, RFIS, SUBMITTALS, AND AS-BUILTS. MAKE RECORDS AVAILABLE TO THE ARCHITECT OR OWNER ON REQUEST.

47. AT SUBSTANTIAL COMPLETION, THE CONTRACTOR SHALL COORDINATE A MINIMUM OF TWO (2) PUNCH LIST WALK-THROUGHS WITH THE ARCHITECT AND OWNER. THEY SHALL COMPLETE ALL PUNCH LIST ITEMS BEFORE FINAL ACCEPTANCE.

48. AT CLOSEOUT, THE CONTRACTOR SHALL SUBMIT DOCUMENTATION INCLUDING WARRANTIES, O&M MANUALS, APPROVED SUBMITTALS, AND RECORD DRAWINGS IN BOTH DIGITAL AND HARD COPY FORMATS.

49. AT CLOSEOUT, THE FINAL PAYMENT WILL BE WITHHELD UNTIL PUNCH LIST ITEMS ARE COMPLETE, FINAL INSPECTIONS PASSED, DOCUMENTATION SUBMITTED, AND THE OWNER ACCEPTS THE WORK.

50. AT CLOSEOUT, THE CONTRACTOR SHALL PROVIDE ALL REQUIRED TESTING AND INSPECTIONS PER CODE OR CONTRACT DOCUMENTS. TESTING AGENCIES MUST BE ACCEPTED BY THE AHJ.

51. AT CLOSEOUT, THE CONTRACTOR SHALL PROVIDE OWNER TRAINING FOR SYSTEMS AND EQUIPMENT PRIOR TO PROJECT CLOSEOUT. COORDINATE AND RECORD TRAINING SESSIONS AS REQUIRED.

52. AT CLOSEOUT, THE CONTRACTOR SHALL PROVIDE WARRANTIES AS SPECIFIED, EFFECTIVE FROM THE DATE OF SUBSTANTIAL COMPLETION UNLESS OTHERWISE AGREED IN WRITING.

53. AT CLOSEOUT, THE CONTRACTOR SHALL COORDINATE ANY REQUIRED POST-CONSTRUCTION COMMISSIONING OR PROCEDURES WITH THE OWNER AND ARCHITECT. FINAL COMPLETION IS NOT CERTIFIED UNTIL ALL CLOSEOUT TASKS ARE ACCEPTED.

DDOT REQUIREMENTS

THE FOLLOWING ARE DDOT STREATERY REQUIREMENTS AND IMPLEMENTATION NOTES. ADDITIONAL REQUIREMENTS MAY APPEAR ON OTHER DRAWING SHEETS OR WITHIN DDOT PERMIT DOCUMENTS. THE CONTRACTOR SHALL REVIEW THIS LIST IN FULL AND NOTIFY THE ARCHITECT OF ANY DISCREPANCIES, CONFLICTS, OR REQUESTS FOR INFORMATION PRIOR TO FABRICATION OR INSTALLATION. ALL WORK SHALL COMPLY WITH DDOT STREATERY GUIDELINES DATED DECEMBER 5, 2024, AND ALL RELATED DDOT PUBLIC SPACE REGULATIONS.

1. OWNER SHALL VERIFY THAT THE FOOD ESTABLISHMENT MEETS ALL DDOT ELIGIBILITY REQUIREMENTS PRIOR TO PERMITTING

2. OWNER SHALL MAINTAIN ALL REQUIRED DDOT, DOB, AND ABCA PERMITS WITH NO OUTSTANDING FEES.

3. STREATERY SHALL BE LOCATED ONLY IN AREAS PERMITTED BY DDOT, INCLUDING PARKING LANES, TRAVEL LANES, OR ALLEYS AS APPLICABLE.

4. OWNER SHALL PROVIDE PROOF OF ADJACENT PROPERTY CONSENT IF THE STREATERY EXTENDS BEYOND THE BUSINESS FRONTAGE.

5. CONTRACTOR SHALL MAINTAIN REQUIRED BUFFERS: 10 FT FROM HYDRANTS AND CROSSWALKS, 15 FT FROM BUS ZONES, 20 FT FROM UNSIGNALIZED INTERSECTIONS, AND 25 FT FROM DRIVEWAYS.

6. OWNER SHALL SEEK PUBLIC SPACE COMMITTEE RELIEF WHEN LOCATION OR BUFFER REQUIREMENTS CANNOT BE MET.

7. CONTRACTOR SHALL INSTALL DDOT-APPROVED CRASH-RESISTANT BARRIERS WITH REQUIRED REFLECTORS AS SHOWN IN APPENDIX 3.

8. ALL BARRIERS SHALL BE LIGHT GRAY, WHITE, OR HAVE A DDOT-APPROVED MURAL FINISH.

9. ENCLOSURE TREATMENTS SHALL BE 32-42 INCHES HIGH, RESIST ALL DDOT LOAD REQUIREMENTS, AND SHALL NOT BE FASTENED INTO THE ROADWAY, CURB, OR SIDEWALK.

10. CONTRACTOR SHALL PROVIDE REQUIRED SAFETY GAPS EVERY 60-100 FT AND AT FIRE DEPARTMENT CONNECTIONS.

11. VERTICAL SUPPORTS ABOVE 42 INCHES SHALL NOT EXCEED 6 INCHES IN WIDTH, AND FULL HEIGHT ENCLOSURES ABOVE THIS HEIGHT ARE PROHIBITED.

12. OVERHEAD STRUCTURES SHALL BE 8-13 FT ABOVE PLATFORM GRADE AND COMPLY WITH ALL DDOT SETBACKS FROM TREES, CROSSWALKS, AND INTERSECTIONS.

13. CONTRACTOR SHALL INSTALL AN ADA-COMPLIANT PLATFORM FLUSH WITH THE SIDEWALK WITH A MAXIMUM 1/2-INCH GAP AND 36-INCH MINIMUM ENTRY WIDTH.

14. PLATFORM SHALL BE ELEVATED WITH LEVELING FEET, MAINTAIN DRAINAGE CLEARANCES, AND SHALL NOT BE BOLTED TO STREET OR SIDEWALK.

15. PLATFORM SHALL INCLUDE ACCESS PANELS FOR UTILITY AND MAINTENANCE NEEDS.

16. CONTRACTOR SHALL MAINTAIN A ONE-FOOT CLEAR DRAINAGE CHANNEL ALONG THE CURB AND PRESERVE ALL EXISTING DRAINAGE PATHS.

17. OWNER SHALL LOCATE AND MARK ALL UTILITIES USING THE APWA COLOR CODE PRIOR TO ANY INSTALLATION.

18. OWNER SHALL REMOVE OR DISASSEMBLE ANY STREATERY ELEMENTS WITHIN FIVE DAYS OF NON-EMERGENCY NOTICE FROM DDOT OR UTILITY OPERATORS.

19. OWNER SHALL REMOVE ALL ELEMENTS IMMEDIATELY UPON EMERGENCY NOTICE FROM DDOT, FEMS, OR UTILITY OPERATORS.

20. OWNER ACKNOWLEDGES THAT DDOT OR UTILITIES MAY REMOVE ELEMENTS AT OWNER'S RISK AND EXPENSE IF OWNER FAILS TO COMPLY.

21. OWNER SHALL MAINTAIN THE STREATERY FREE OF TRASH, GRAFFITI, RODENTS, AND UNSAFE CONDITIONS AT ALL TIMES.

22. OWNER SHALL REMOVE ALL FURNITURE AND REMOVABLE ELEMENTS DURING ANY DECLARED SNOW EMERGENCY.

23. CONTRACTOR SHALL INSTALL TWO DDOT-COMPLIANT STREATERY SIGNS LISTING BUSINESS NAME, HOURS, CAPACITY, AND EMERGENCY CONTACT.

24. NO ADDITIONAL SIGNAGE, ADVERTISING, OR LOGOS SHALL BE APPLIED TO ANY STREATERY ELEMENTS.

25. MAXIMUM SEATING CAPACITY SHALL BE DETERMINED BY TOTAL SQUARE FOOTAGE DIVIDED BY 15, ROUNDED DOWN. ALL SEATING SHALL BE SET BACK ONE FOOT FROM BARRIERS AND INCORPORATE AT LEAST ONE ADA-COMPLIANT TABLE.

26. OWNER SHALL NOT PLACE OR RELOCATE ANY PUBLIC REALM ELEMENTS INCLUDING BIKE RACKS, BENCHES, OR TRASH CANS.

27. LIGHTING SHALL BE CLEAR, WARM, NON-FLASHING, NON-STROBING, AND SHALL NOT BE DIRECTED AT THE STREET OR SIDEWALK.

28. ONLY ONE ELECTRICAL CONNECTION IS PERMITTED, AND ALL CORDS SHALL BE A MINIMUM OF 8 FT ABOVE GRADE IN APPROVED CONDUIT. ELECTRICAL CORDS SHALL RUN PERPENDICULAR TO THE BUILDING AND SHALL NOT CONTACT STREET TREES OR PUBLIC INFRASTRUCTURE.

29. HEATERS SHALL BE INSTALLED ONLY IN FULL COMPLIANCE WITH FEMS REQUIREMENTS, INCLUDING ALL REQUIRED CLEARANCES AND PERMITS.

30. OWNER SHALL NOT PERMIT FOOD PREPARATION, ALCOHOL PREPARATION, GENERATORS, LIVE MUSIC, TELEVISIONS, ENTRY FEES, OR ROPED-OFF ACCESS WITHIN THE STREATERY.

31. OWNER SHALL DISPLAY THE DDOT STREATERY PERMIT AND APPROVED SITE PLAN IN A FRONT WINDOW VISIBLE FROM THE SIDEWALK.

32. ANY CHANGES TO APPROVED STREATERY DESIGN, STRUCTURE, OR FURNISHINGS SHALL REQUIRE A NEW PUBLIC SPACE PERMIT.

ARCHITECT

wood + starr

3312 7th Street NE, Washington, DC 20017

CONSULTANTS

PROJECT

QUEEN'S ENGLISH

STREATERY
3410 11TH STREET NW
WASHINGTON, DC 20010

PROFESSIONAL SEAL



PROFESSIONAL CERTIFICATION:
I HEREBY CERTIFY THAT THESE DOCUMENTS WERE PREPARED
OR APPROVED BY ME, AND THAT I AM A DULY LICENSED
PROFESSIONAL ARCHITECT UNDER THE LAWS AND
REGULATIONS OF THE DISTRICT OF COLUMBIA.

SUBMITTALS

#	NOTE	DATE
	PERMIT SET	12/15/25

KEY PLAN

SHEET NAME


PROJECT GENERAL
NOTES & DDOT
REQUIRMENTS

SHEET NUMBER


G1.01

DATE	05/12/2025
PROJECT #	24024.00


STREATERY PLAN NOTES

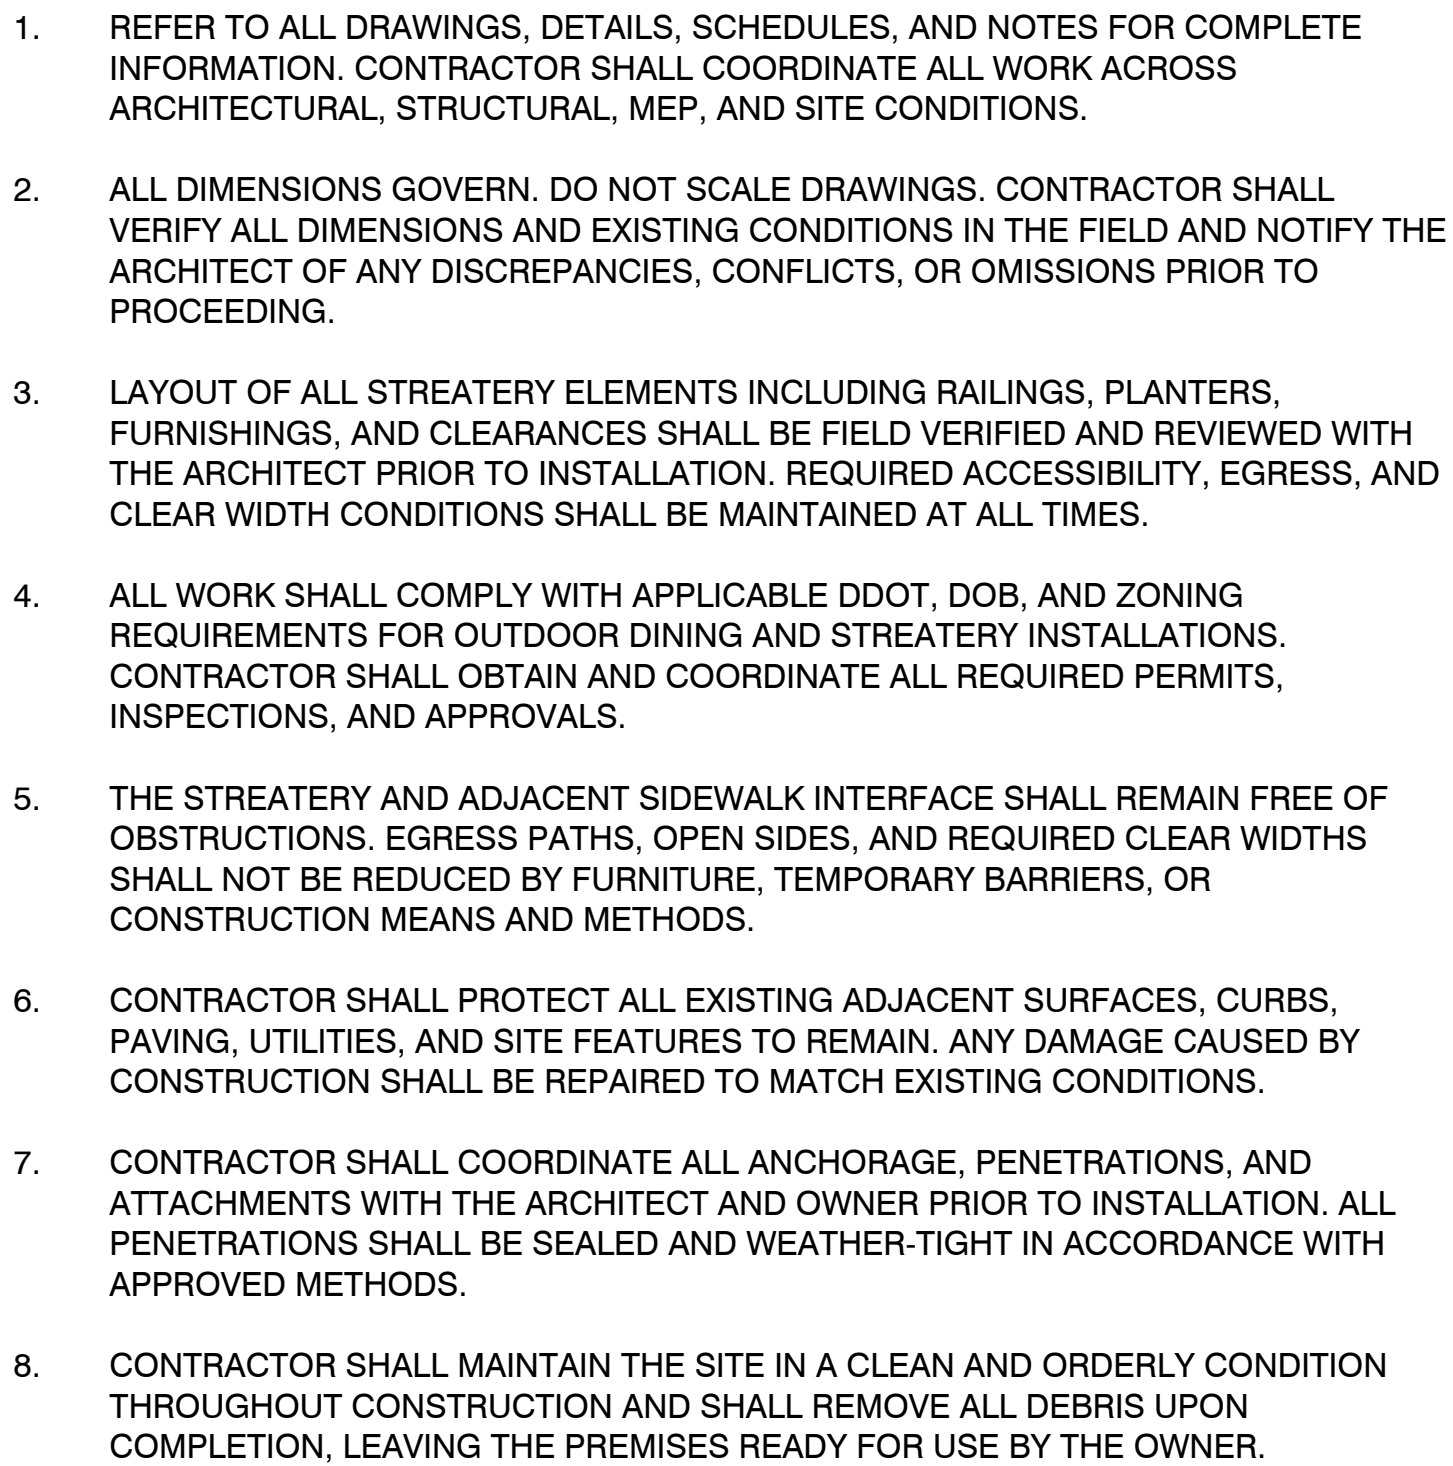

7 | SECTION 1
1/2" = 1'-0"

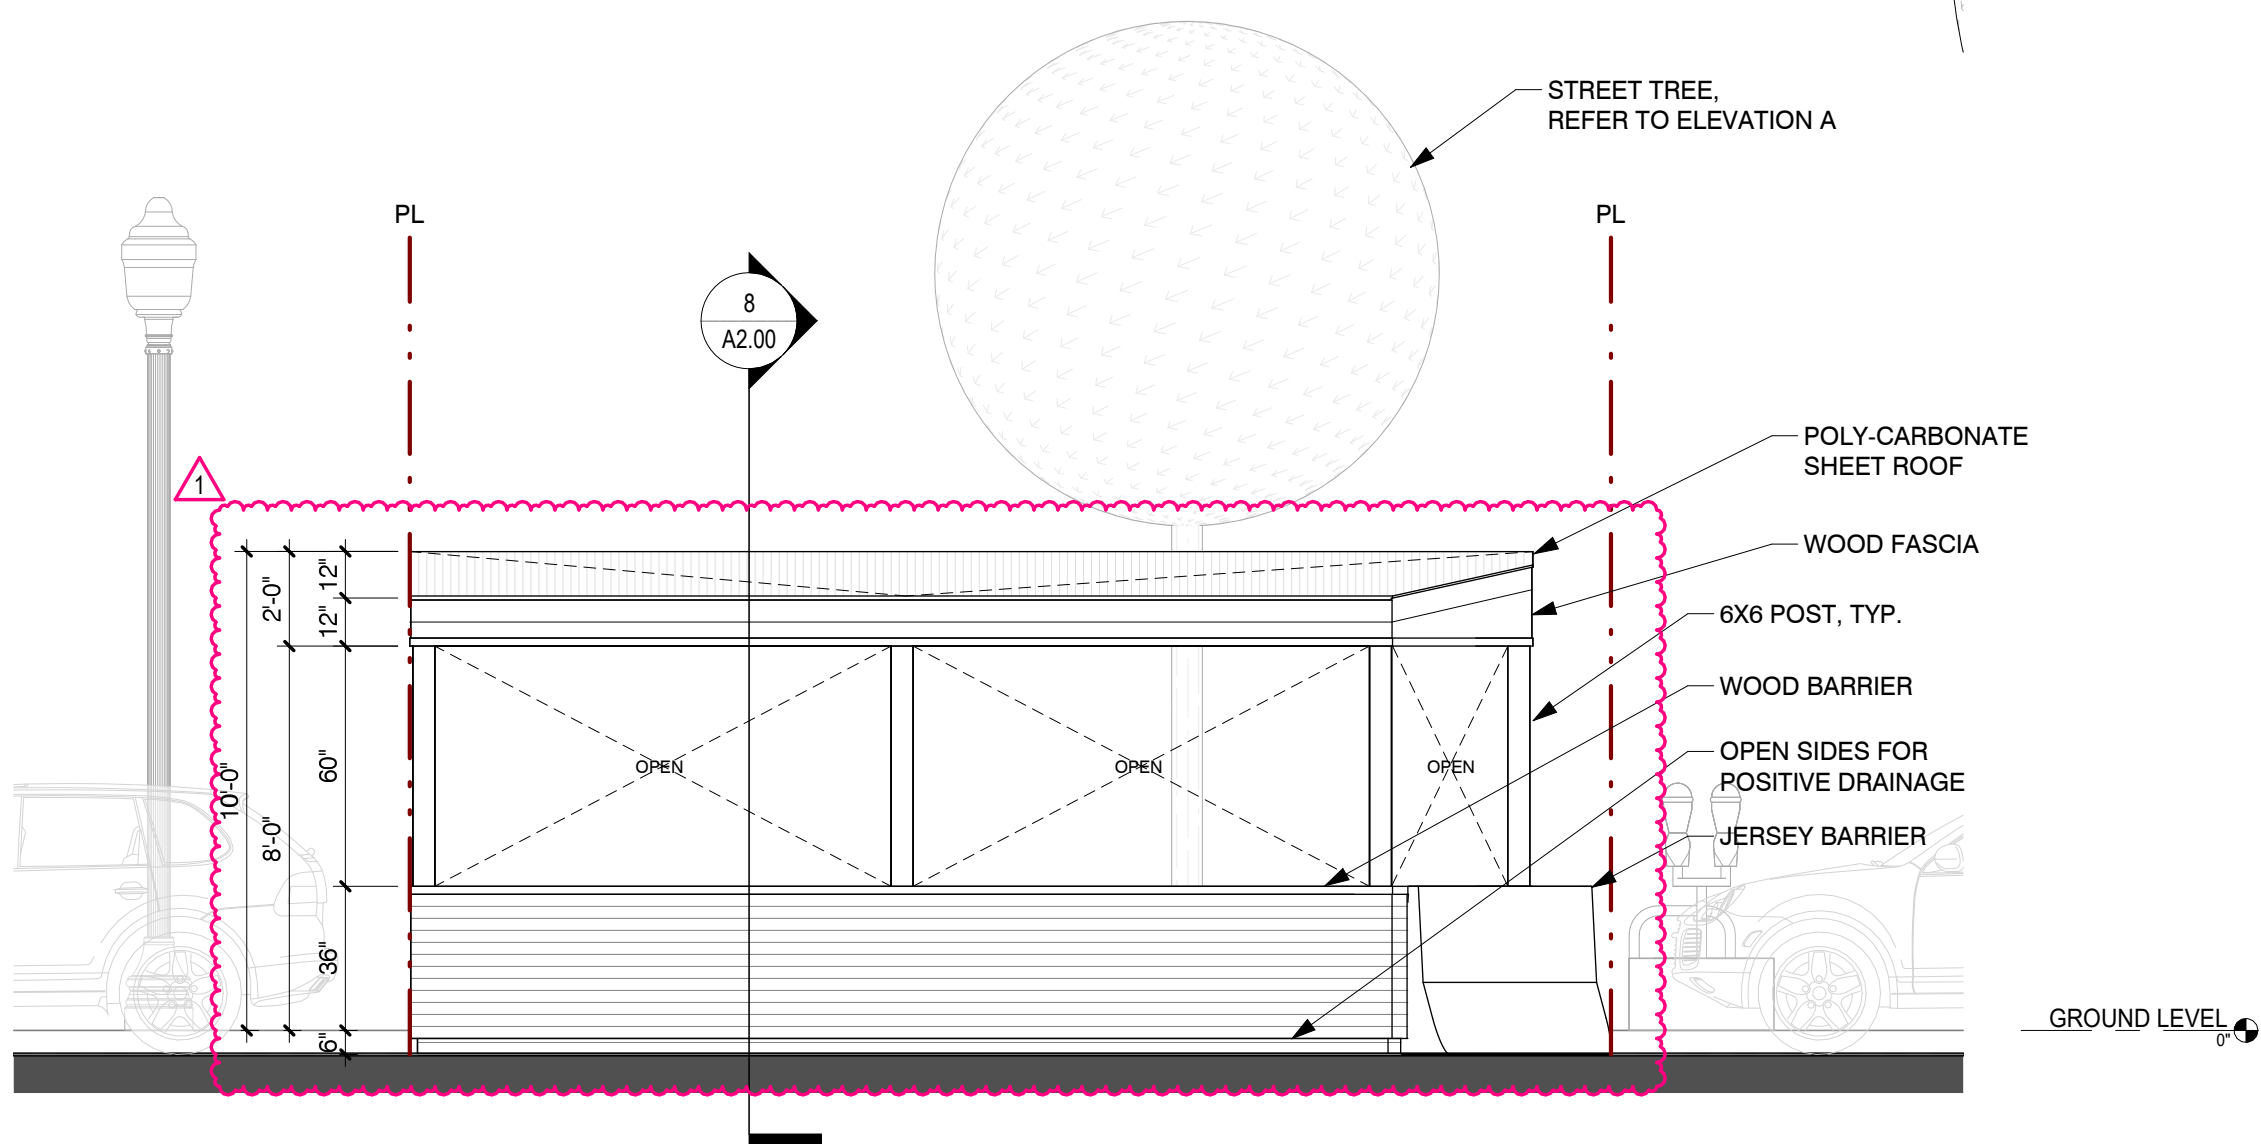


4 | ELEVATION B

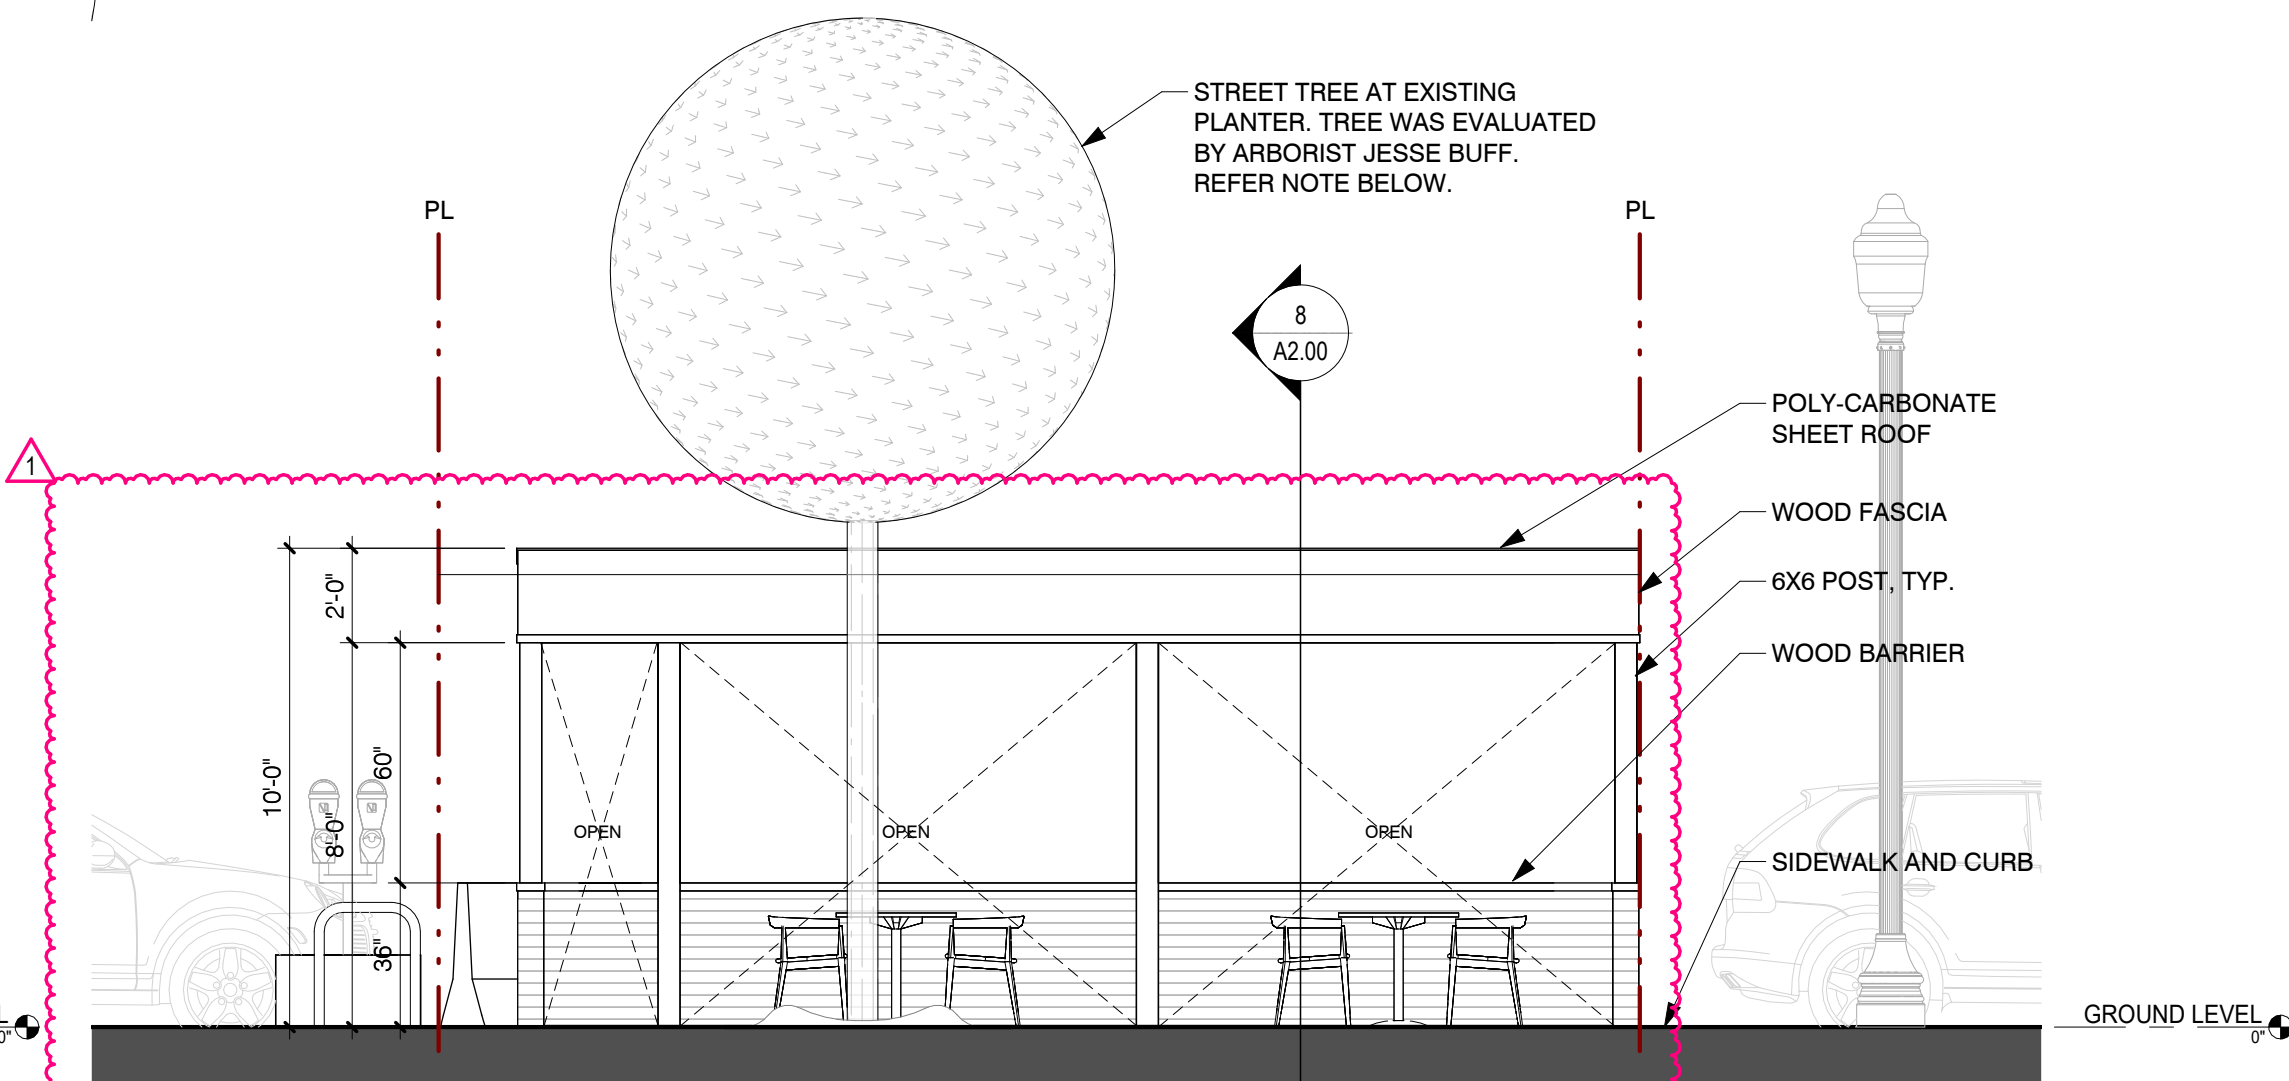

3 | ELEVATION A
1/4" = 1'-0"

NOTE: RAISED PLANTER BED TO BE REMOVED. ADD A 2-3" LAYER OF DOUBLE SHREDDED HARDWOOD MULCH TO THE TREE PLANTING SPACE, BUT DO NOT PLACE UP AGAINST OR MOUND AROUND THE ROOT FLARE

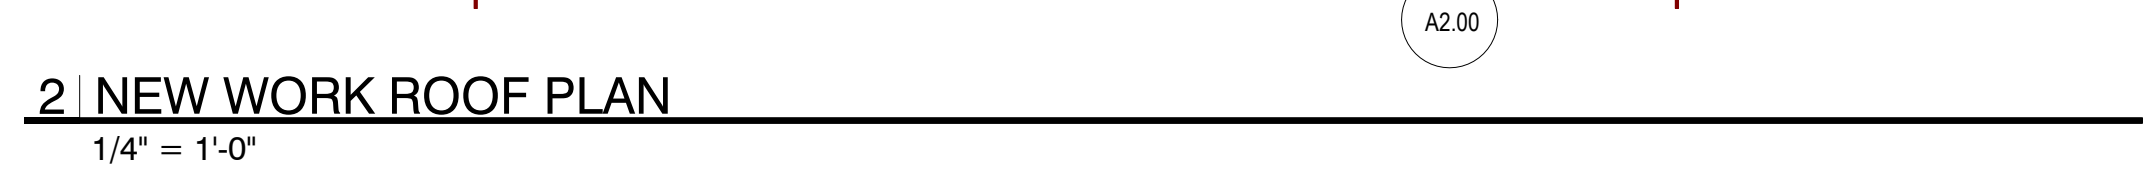

2 | NEW WORK ROOF PLAN




1 | NEW WORK STREATERY PLAN
1/4" = 1'-0"

#	NOTE
1	STREET TREE AT EXISTING PLANTER. TREE WAS EVALUATED BY ARBORIST JESSE BUFF. REFER NOTE BELOW. EXISTING RAISED PLANTER BED TO BE REMOVED. 2" TO 3" LAYER OF DOUBLE SHREDDED HARDWARE MULCH ADDED TO THE TREE PLANTING SPACE.
2	REMOVABLE 3/8" STEEL PLATE. BOLT TO PLATFORM SO THAT NO TRIP HAZARD IS CREATED AND THAT THERE IS NO RISE BETWEEN STREETERY AND CURB (3/8" MAX RISE FOR ACCESSIBILITY).
3	NEW FLOOR, TYP. PROVIDE PRESSURE TREATED 2X4 SLEEPERS ON ADJUSTABLE PEDESTALS. MAINTAIN POSITIVE DRAINAGE. FINISH WITH TREX DECKING, OR SIMILAR, WITH COUNTERSUNK SCREWS.
4	PROVIDE ACCESS PANEL FOR ACCESS.
5	PRESURE TREATED 6X6 POSTS, TYP. FINISH AS REQUIRED.
6	PRESURE TREATED 2X4 BARRIER, TYP. FINISH AS REQUIRED.
7	POLYCARBONATE ROOFING SHEETS, TYP. FINISH AS REQUIRED. PROVIDE CONTINUOUS FLASHING.
8	PROVIDE A SINGLE ELECTRICAL CONNECTION FROM THE FOOD ESTABLISHMENT TO THE STREATERY. ELECTRICAL CORD SHALL BE ROUTED IN CONDUIT, RUN PERPENDICULAR ALONG THE SHORTEST PATH, MAINTAIN 8 FEET MINIMUM CLEARANCE ABOVE THE SIDEWALK, AND SHALL NOT INTERFERE WITH PUBLIC INFRASTRUCTURE. CONNECT TO EXISTING EXTERIOR GFCI JUNCTION BOX AT BUILDING FACE AS REQUIRED FOR USE ON EXTERIOR LED LIGHTING ONLY.
9	STREATERY LIGHTING SHALL BE CLEAR, WARM, STEADY, AND LOW INTENSITY. LIGHTING SHALL NOT FLASH, STROBE, OR PROJECT INTO THE SIDEWALK OR ROADWAY. LOW-VOLTAGE, SOLAR, OR BATTERY-POWERED LIGHTING IS PERMITTED.
10	STORMWATER CHANNEL BELOW FLOOR AT CURB. PROVIDE POSITIVE UNOBSTRUCTED DRAINAGE.

wood + starr

CONSULTANTS

QUEEN'S ENGLISH

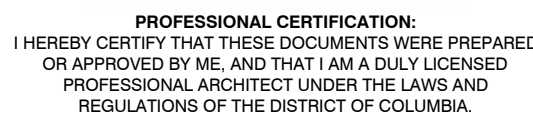PROFESSIONAL SEAL


#	NOTE	DATE
	PERMIT SET	12/15/25
1	REVISION 1	03/16/26

NEW WORK PLAN & NOTES

A2.00

DATE	05/12/2025
PROJECT #	24024.00


CONCRETE BLOCK SPECS

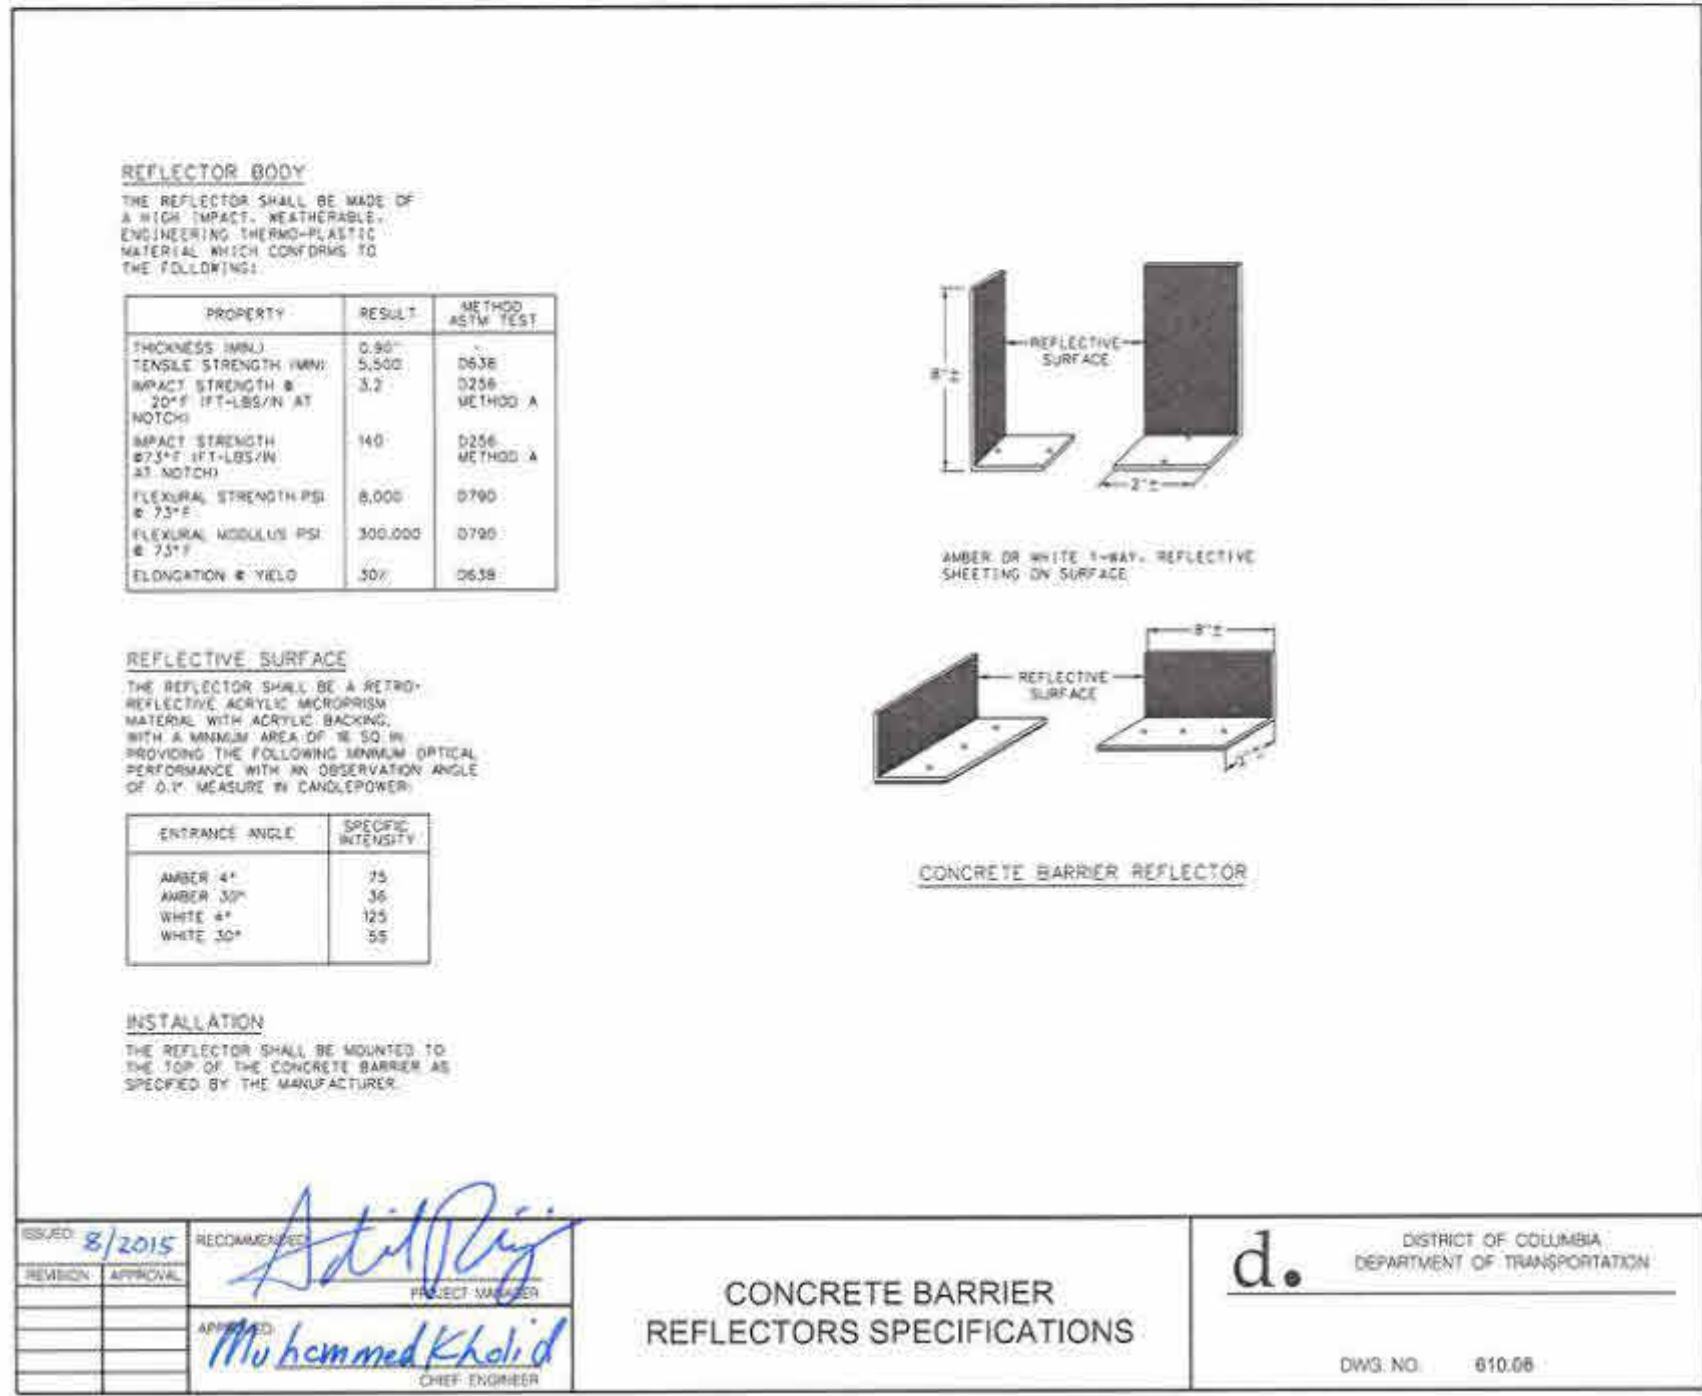

Private Utility Operator	Contact Information
DC Water	202-612-3400
PEPCO	877-737-2662
Verizon	804-644-3108
Washington Gas	844-927-4427

Color	Description
	White: Proposed Excavation
	Pink: Temporary Survey Markings
	Red: Electric Power Lines, Cables, Conduit, and Lighting Cables
	Yellow: Gas, Oil, Steam, Petroleum, or Gaseous Materials
	Orange: Communication, Alarm or Signal Lines, Cables or Conduit
	Blue: Potable Water
	Purple: Reclaimed Water, Irrigation, and Slurry Lines
	Green: Sewers and Drain Lanes

Type 2 Arterials, Collector, and Local Streets

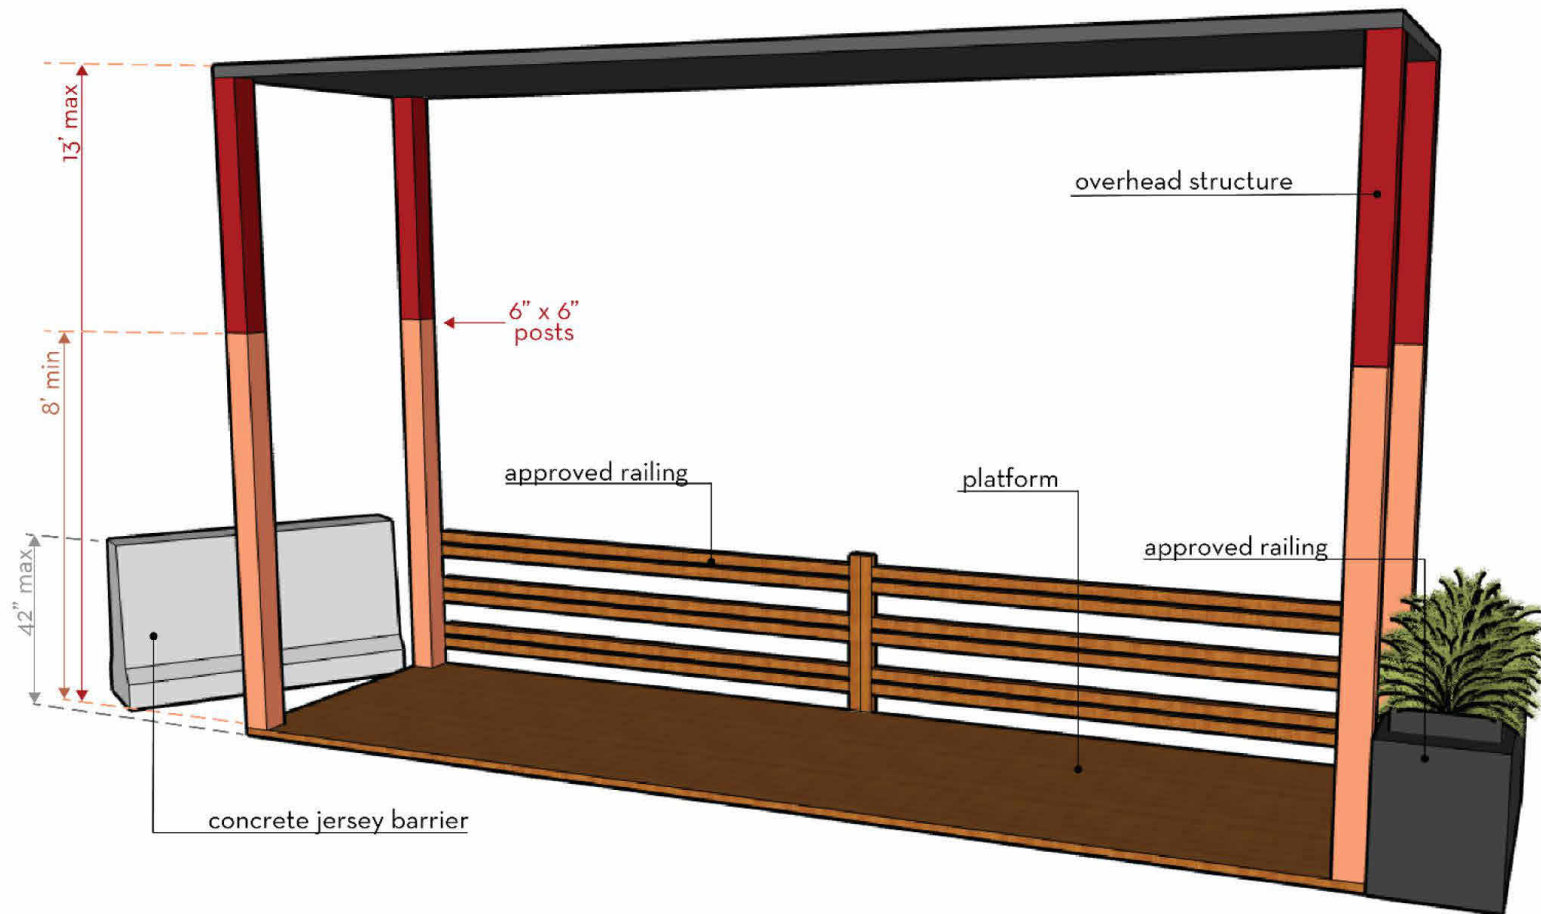

KEY PLAN

DATE	05/12/2025
PROJECT #	24024.00